OFN ACCESS NETWORK
OPTICAL FIBRE DEVELOPMENT FOR
DIALOG MOBILE
SITE CONNECTIVITY

INTERNATIONAL COLLEGE OF BUSINESS & TECH LTD & TECH LTD
CX033107

MAITHRIPALA SENANAYAKE MAWATHA,
ANURADHAPURA
(8.3391868,80.4117676)

SEGMENT	ROAD NAME /NUMBER	AUTHORITY	CONSTRUCTION MTDS	DISTANCE NEW	DISTANCE OLD	POLE	MH
DAM-JAF 1500 ~ 2R BRACKET	MAITHRIPALA SENANAYAKA MAWATHA	RDA	AREIAL	–	88.0m	–	–
			TOTAL DISTANCE WITHOUT COIL		88.0 m		
			TOTAL DISTANCE WITH COIL		113.0 m		

AS BUILT DRAWING FOR
OSP

DIALOG BROADBAND NETWORKS (PVT) LTD
475, UNION PLACE
COLOMBO 02
SRI LANKA

LUMINEX PLC
NO. 24, NEW GALLE ROAD
MORATUWA
SRI LANKA.

LEGEND FOR OFN DRAIWNG

Existing HDD Path

Proposed HDD Path

Existing Aerial Path

Proposed Aerial Path

Existing Open Trench Path

Proposed Open Trench Path

Feeder Cable

Distribution Cable

Drop Cable

Existing Micro Trench Path

Proposed Micro Trench Path

CMC Path

Pending Path

Pole with Strut / Existing or Proposed

Pole with Stay / Existing or Proposed

Pole with Concrete / Existing or Proposed

Proposed 9m Pole

Proposed 6.7m Pole

Proposed 8m Pole

Proposed GI Pole

Existing 9m Pole

Existing 6.7m Pole

Existing8m Pole

Existing GI Pole

ML/HH2/A — Proposed Manhole

WAD-MAT/45/B — Existing Manhole

CMC Handhole

Pending Handhole

Existing FTC

Existing Pole Mount FDP (With SPliiter #)

Existing Under Ground FDP (With splitter #)


Proposed FTC

Proposed Pole Mount FDP (With Splitter #)

Proposed Under Ground FDP (With splitter #)

Customer Location (With number of Location)

Proposed HDD Pit (L-1.0m x W-1.0m x H-1.5m)

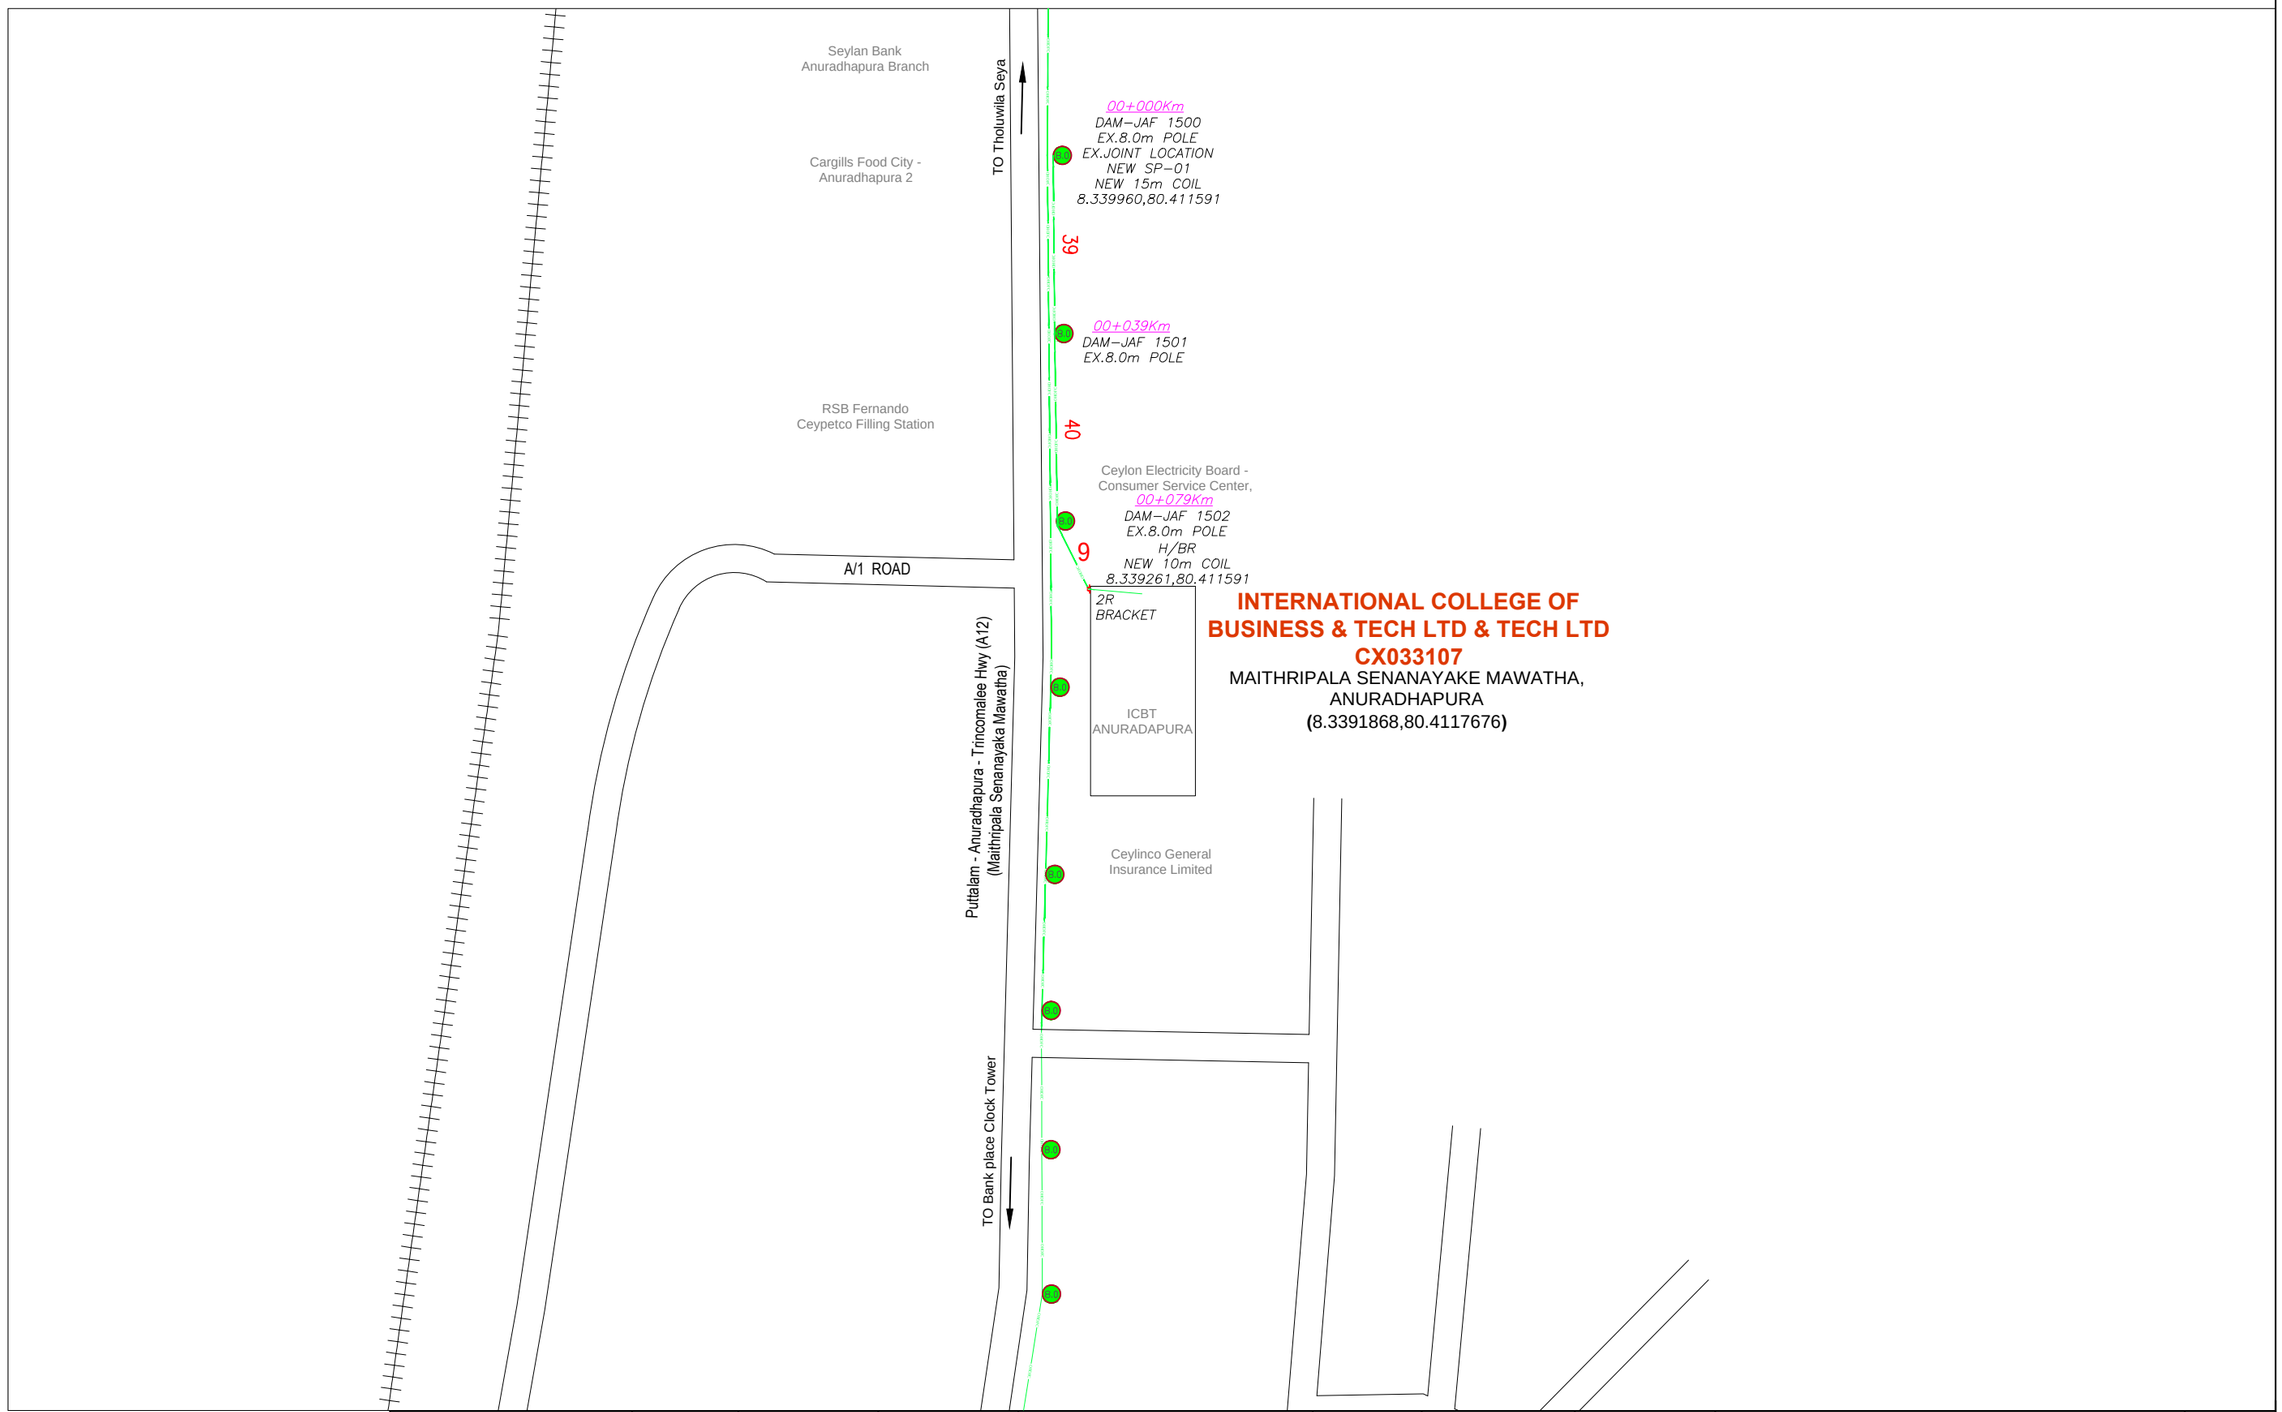

INTERNATIONAL COLLEGE OF BUSINESS & TECH LTD & TECH LTD
CX033107
MAITHRIPALA SENANAYAKE MAWATHA,
ANURADHAPURA
(8.3391868,80.4117676)

DRAWING TITLE : OSP

CONTRACTOR LOGO

LUMINEX PLC
NO. 24, NEW GALLE ROAD
MORATUWA
SRI LANKA.

	DRAWN BY	CHECKED BY
NAME / SIGNATURE	DAYAN	ASIRI
DESIGNATION	DRAU.	A.Eng.
DATE	2026.05.19	2026.05.19

DIALOG BROADBAND NETWORKS (PVT) LTD
475, UNION PLACE
COLOMBO-02
SRI LANKA

	CHECKED BY	ACCEPT BY
NAME / SIGNATURE		
DESIGNATION		
DATE		

INTERNATIONAL COLLEGE OF BUSINESS & TECH LTD & TECH LTD - CX033107
MAITHRIPALA SENANAYAKE MAWATHA,
ANURADHAPURA
(8.3391868,80.4117676)

SCALE

PAGE NO
01 OF 01